




2930 Northeast  
2nd Court  
Miami, Florida  
33137  
305.545.4964

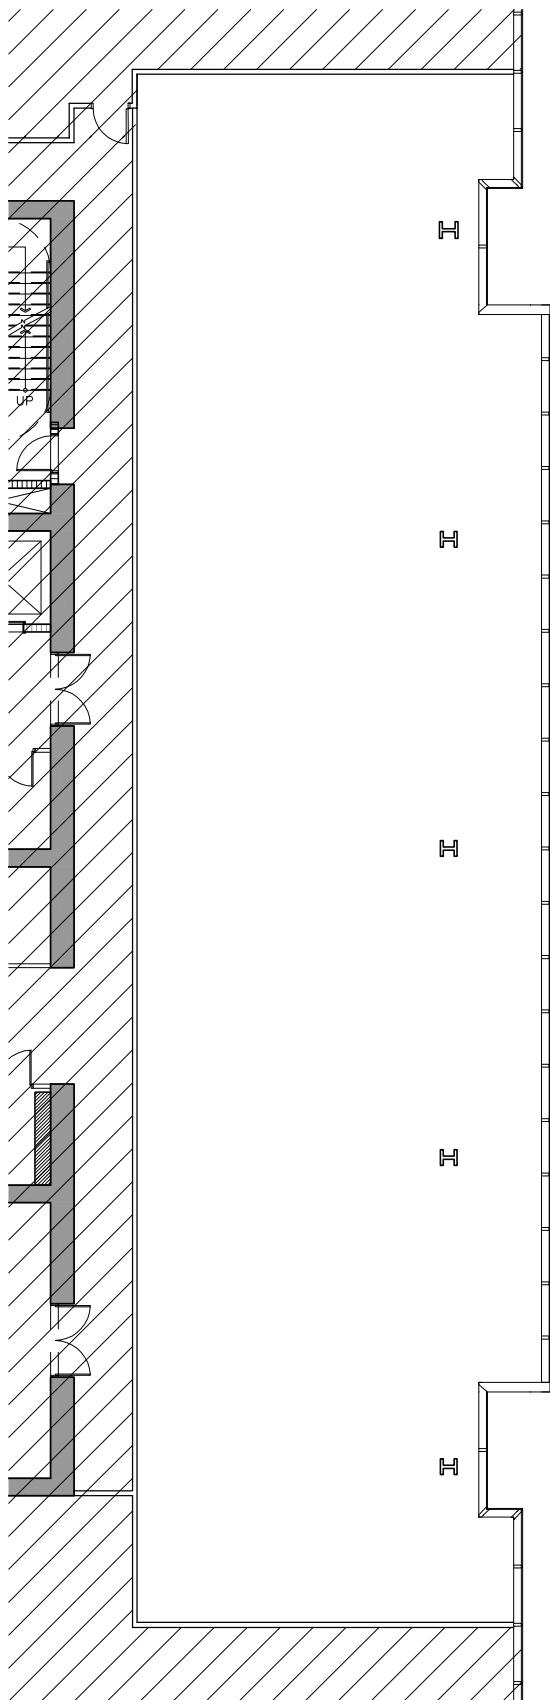

## Wells Fargo Center

As Built – Suite 2920

1/16"=1'-0"



PROJECT NO:	1112-00
DRAWN BY:	I.G.
DATE:	02/04/19
SCALE:	AS-SHOWN
SHEET NO:	SK-1