




insight
design

2930 Northeast
2nd Court
Miami, Florida
33137
305.545.4964

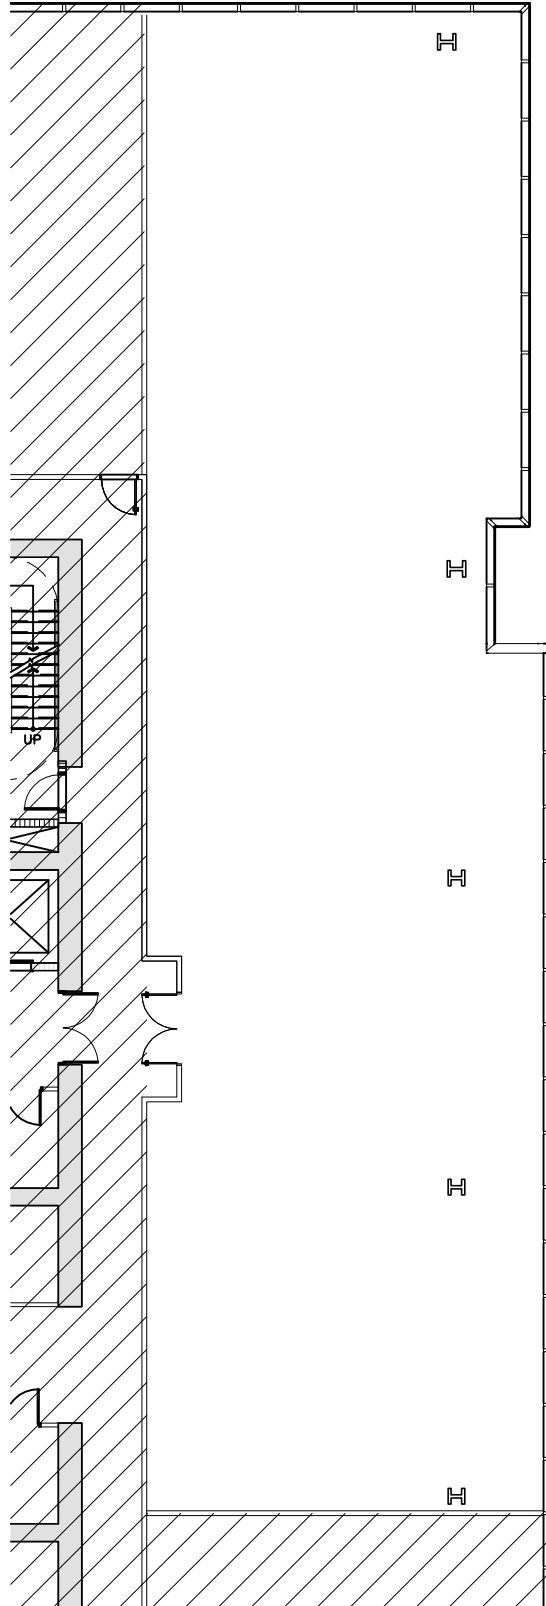


Management & Leasing by
CUSHMAN & WAKEFIELD

Wells Fargo Center

As Built - Suite 2750

1/16"=1'-0"

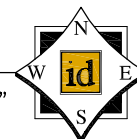

PROJECT NO:	1112-00
DRAWN BY:	I.G.
DATE:	02/04/19
SCALE:	AS-SHOWN
SHEET NO:	SK-1