




insight  
design

2930 Northeast  
2nd Court  
Miami, Florida  
33137  
305.545.4964

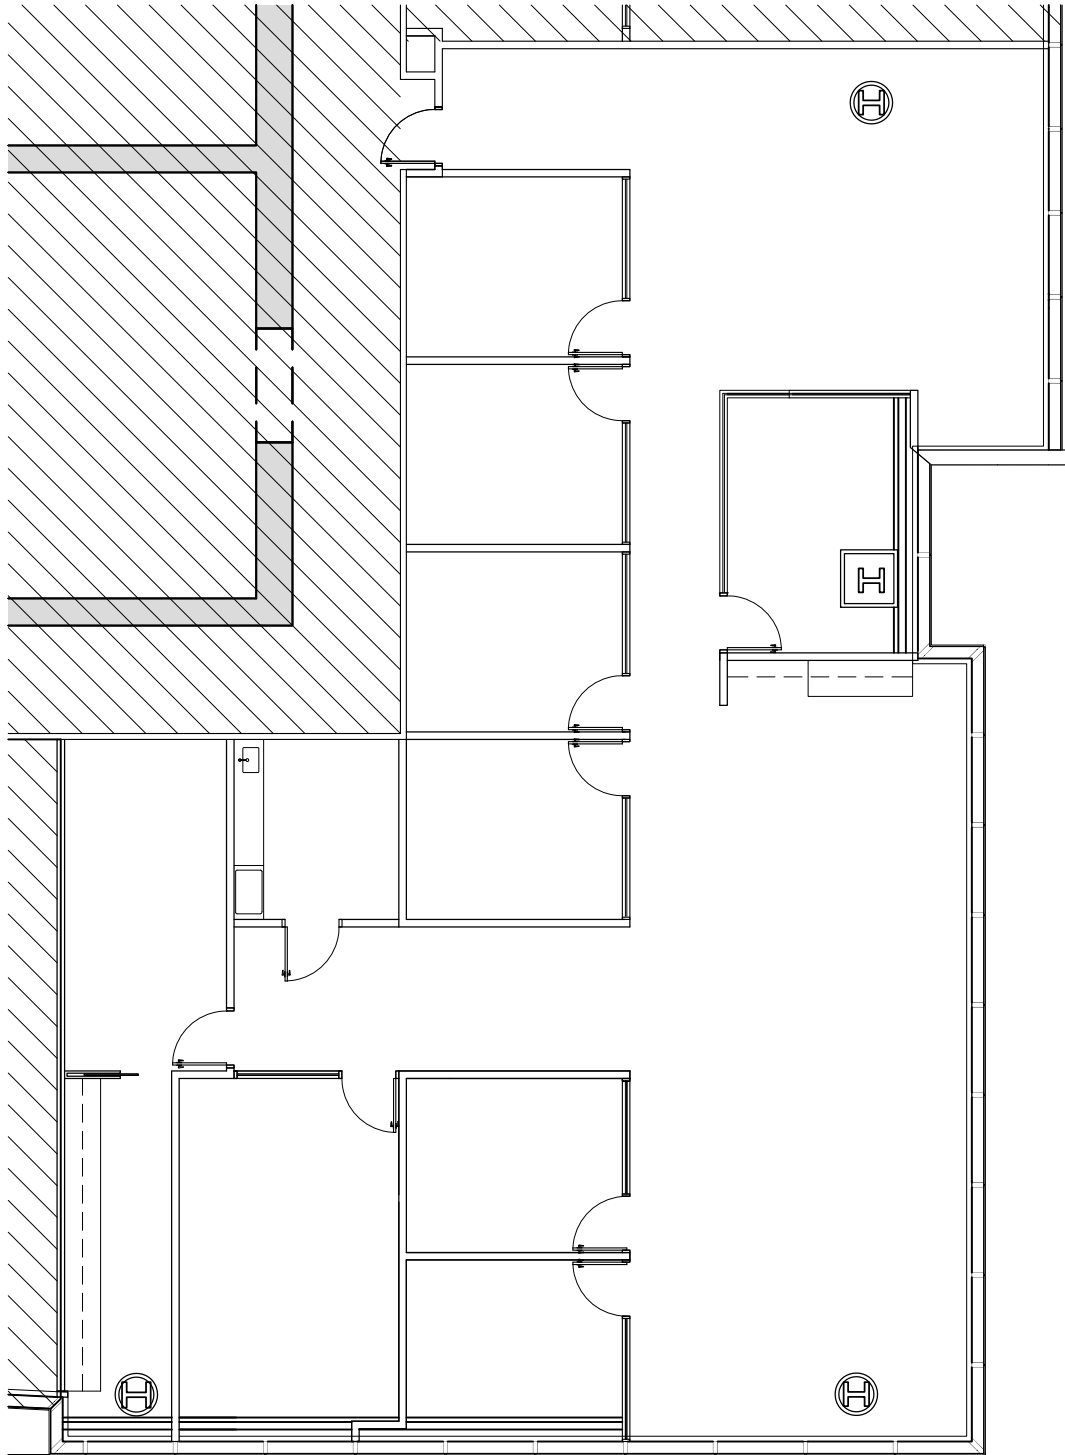

Management & Leasing by  
**CUSHMAN & WAKEFIELD**

# Wells Fargo Center

As Built - Suite 3750

3/32" = 1'-0"



|             |          |
|-------------|----------|
| PROJECT NO: | 1112-00  |
| DRAWN BY:   | I.G.     |
| DATE:       | 02/04/19 |
| SCALE:      | AS-SHOWN |
| SHEET NO:   | SK-1     |