




insight
design


2930 Northeast 2nd
C o u r t
Miami, Florida 33137
3 0 5 . 5 4 5 . 4 9 6 4

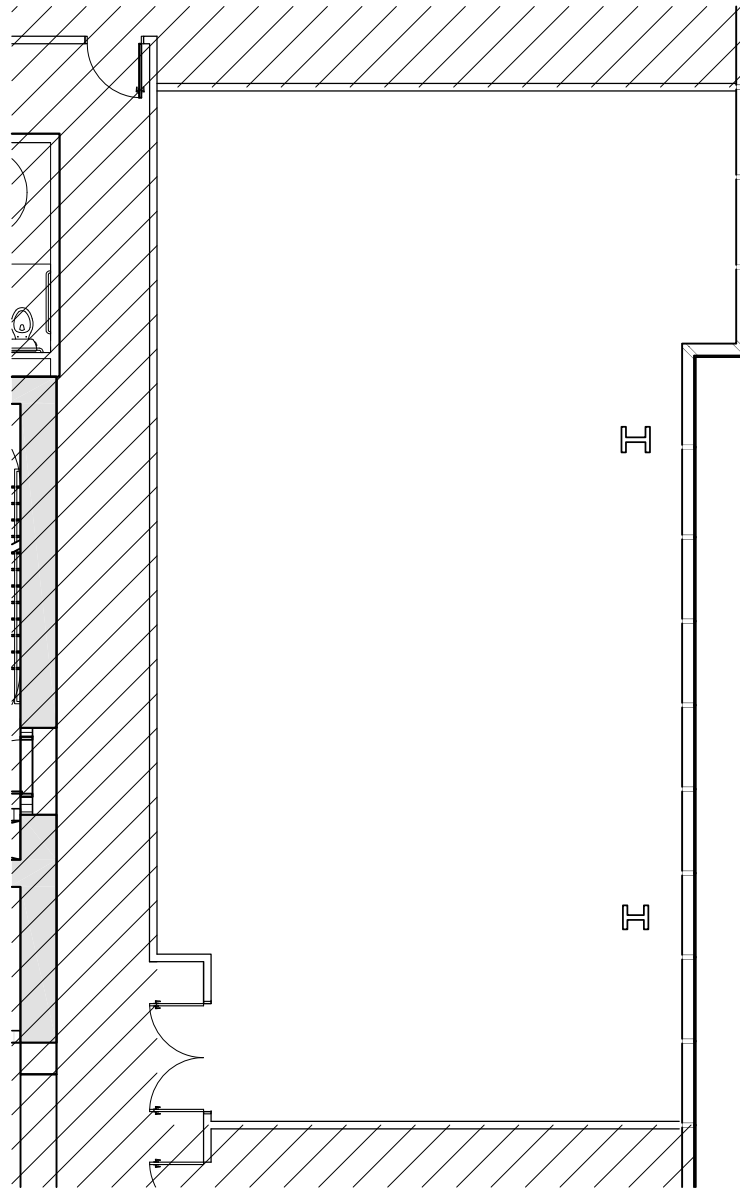

Wells Fargo Center

As Built - Suite 2050

3/32" = 1'-0"

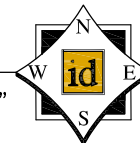

Management & Leasing by
 CUSHMAN &
WAKEFIELD

PROJECT NO:	1112-00
DRAWN BY:	I.G.
DATE:	02/19/19
SCALE:	AS-SHOWN
SHEET NO:	SK-1